

#### 1 Bailey Street Port Carling, ON P0B 1J0

E: planning@muskokalakes.ca P: 705-765-3156 F: 705-765-6755

# **COMMITTEE OF ADJUSTMENT - NOTICE OF HEARING**

THE CORPORATION OF THE TOWNSHIP OF MUSKOKA LAKES

To consider an application for a proposed minor variance to Zoning By-law 2014-14 pursuant to Section 45 of the Planning Act, R.S.O., 1990, Chapter P. 13, as amended. **This notice has been sent to you for information and does not require any response unless you wish to make one.** 

File No.: A-01/25 Roll No.: 9-2-044

Owner:	1000301083 Ontario Limited., 1519 Highway 118 West, Unit #9, Bracebridge,				
	ON, P1L 1W0				
Address &	1519 Muskoka Road 118 West, Unit #9				
Description:	Lot 12, Concession 4, Part of Lot 29, Lot 30, and Part of Lot 31 Plan 13,				
	(Monck)				
Zoning:	Waterfront Residential (WR1) Lake Muskoka (Category 1) Schedule: 45				
Hearing Date: Monday, March, 10th, 2025 at 9:00 a.m.					

Take further notice that this public hearing will be held in a hybrid forum with electronic Zoom participation, and in-person format for those wishing to attend in-person. The hearing will be held in the **Council Chambers, Municipal Office, 1 Bailey Street, Port Carling, ON**. Should you wish to view an electronic copy of the Notice of Hearing for the above-noted application, please visit <a href="https://www.muskokalakes.ca/planning-notices/">https://www.muskokalakes.ca/planning-notices/</a> or scan the QR code.



#### **Explanation of the Purpose and Effect:**


The applicant proposes to recognize an as-built sundeck and landing. The following is a summary of the requested variances:

Variance	ZBL 2014-14 Section(s)	Description	Permitted	Proposed	Variance	Proposal
А	4.1.3	Minimum Required Front Yard Setback	66 ft.	44.5 ft.	21.5 ft.	To Recognize an As-built Landing.
В	4.1.3	Minimum Required Interior Side Yard Setback	15 ft.	12.5 ft.	2.5 ft.	To Recognize an As-built Sundeck.
С	4.1.3	Minimum Required Interior Side Yard Setback	15 ft.	12.5 ft.	2.5 ft.	To Recognize an As-built Landing.

A key map of the subject property and the applicants' site plan and any drawings are included in this notice.



# Key Map, A-01/25 (1000301083 ONTARIO INC.)

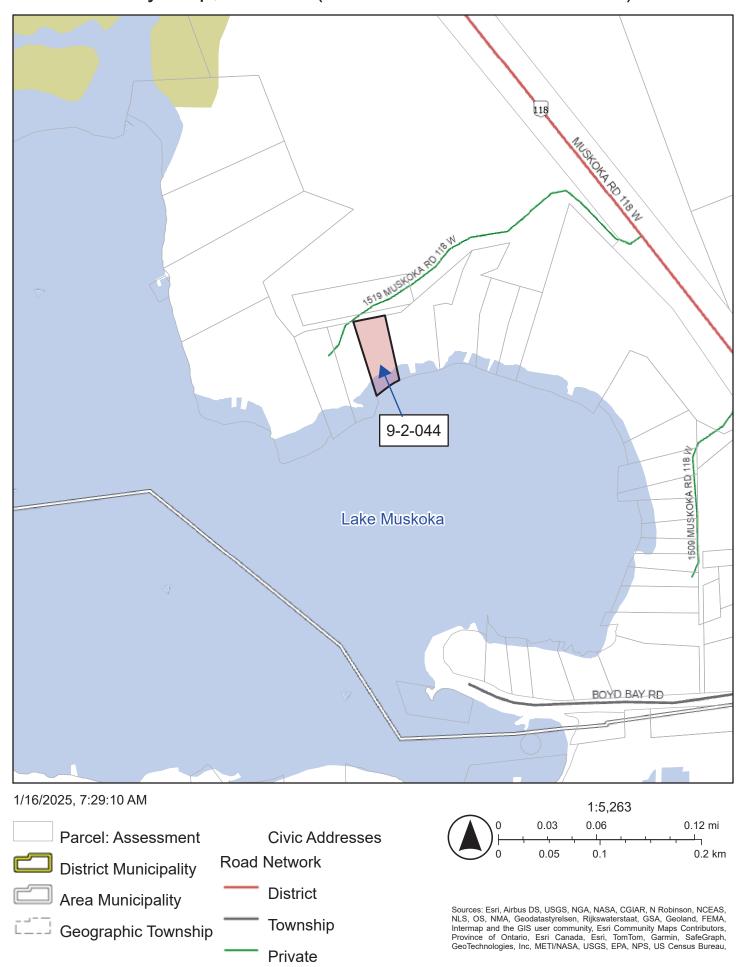

NOT A PLAN OF SURVEY. FOR INFORMATIONAL PURPOSES ONLY.

For more information, please contact the Planning Division weekdays between 8:15 a.m. and 4 p.m. at the Municipal Office, or at <a href="mailto:planning@muskokalakes.ca">planning@muskokalakes.ca</a> or by phone at (705) 765-3156. **Please quote the file number noted above.** 

## **How to Participate:**

### **Submit Comments in Writing**



Submit comments to <a href="mailto:planning@muskokalakes.ca">planning@muskokalakes.ca</a>, deliver in-person, or mail to P.O. Box 129, 1 Bailey Street, Port Carling, ON, P0B 1J0. For correspondence to be included on the agenda, please submit your comments by: <a href="mailto:March 5th">March 5th</a>, 2025

Personal information collected in response to this Notice of Hearing will be used to assist staff and Council to process this application and will be made public.

### **Active Participation In-Person or on Zoom**



Hybrid hearings are held at 9:00 a.m. on the above-noted hearing date in Council Chambers at the Municipal Office. For more information about participating via Zoom, visit www.muskokalakes.ca/zoom

If you wish to speak to the Committee of Adjustment at the hearing by electronic participation, please contact <a href="mailto:planning@muskokalakes.ca">planning@muskokalakes.ca</a> by 9:00 a.m. on the regular business day preceding the scheduled hearing.

### **Watch the Hearing Online**



You can access the hearing from YouTube on the Township of Muskoka Lakes YouTube Channel. If the live webcast fails, the hearing recording will be posted under the Government Portal on www.muskokalakes.ca

**FAILURE TO PARTICIPATE IN HEARING:** If you do not participate in the hearing it may proceed in your absence and, except as otherwise provided in the Planning Act, you will not be entitled to any further notice in the proceedings.


**DECISION & APPEALS:** If you wish to be notified of the decision of the Committee of Adjustment in respect to this application, you must make a written request to <a href="mailto:planning@muskokalakes.ca">planning@muskokalakes.ca</a>. Furthermore, **no one other than** the applicant, the municipality, certain public bodies and the minister may file an appeal of the decision of the Committee of Adjustment in respect of the proposed variance. If they do not make a written submission to the Secretary Treasurer before the variance is approved or refused, then the Ontario Land Tribunal may dismiss the appeal.

**PLEASE NOTE:** The Committee of Adjustment is a judicial body which makes decisions solely on the information gathered as a Committee. Committee members are not to be contacted prior to the hearing date to avoid a conflict of interest.

Dated at the Township of Muskoka Lakes this 14th day of February, 2025.

Chelsea Ward, Secretary-Treasurer Committee of Adjustment planning@muskokalakes.ca



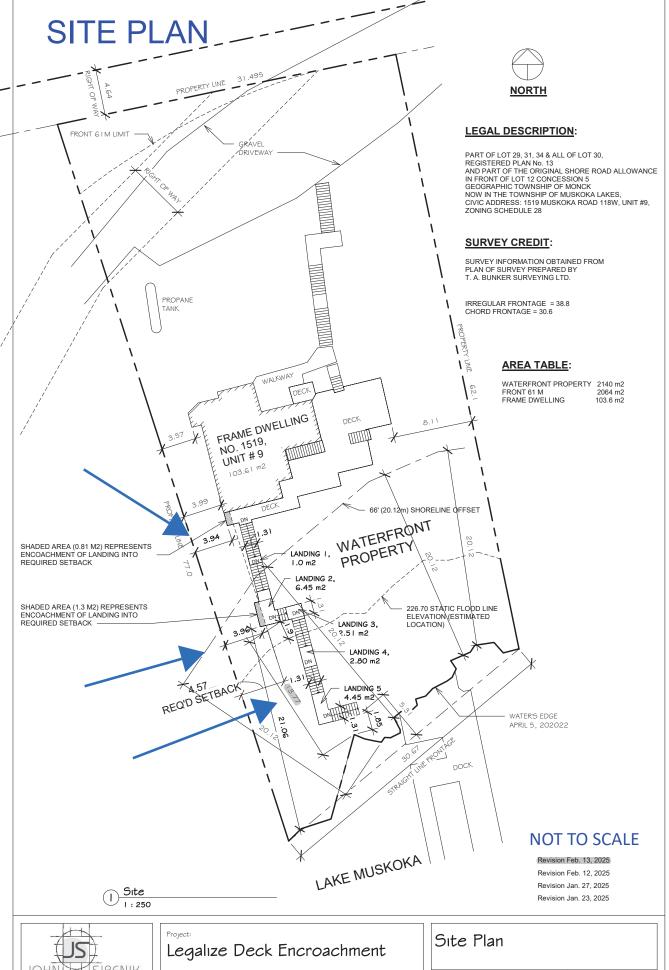




1519 Muskoka District Road 118W, Unit 9 Muskoka Lakes, ON PIL 1W8

Project number 2024-18	
Date January 3, 2025	ΑI
Drawn by J.S.	
Checked by J.S.	Scale 1 : 250

# **DECK ELEVATIONS**

#### FOR INFORMATIONAL PURPOSES ONLY

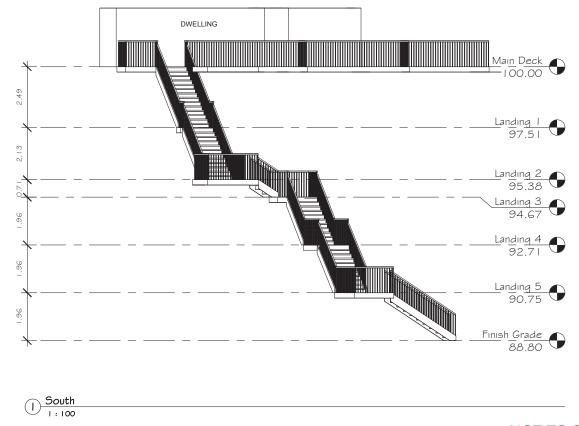

#### **NOT TO SCALE**



Project:

# Legalize Deck Encroachment

1519 Muskoka District Road 118W, Unit 9 Muskoka Lakes, ON PIL 1W8

Elevations
------------

Project number 2024-18	
Date January 3, 2025	A2
Drawn by J.S.	• 1
Checked by J.S.	Scale 1 : 100